



ELEVATION

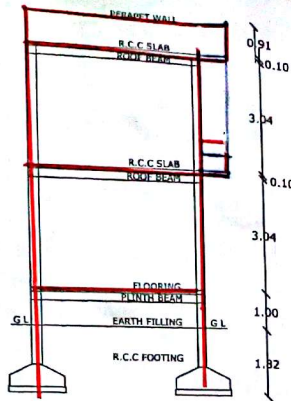

SECTION AT - AA

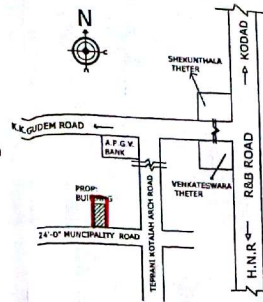

LOCATION-MAP NOT TO SCALE

PLAN SHOWING THE PROPOSED CONSTRUCTION OF RESIDENTIAL GROUND FLOOR & FIRST FLOOR BUILDING SITUATED IN SY.NO:-104<sup>th</sup> & 1050, PLOT NO: 5/A, BLOCK NO.12, MARKET YARD AREA, KODAD (MUNICIPALITY), NALGONDA (DT), TELANGANA. BELONGS TO:- SRI. GUDIMALLA SRIHARI S/O VENKATAPPAIAH.

SPECIFICATION	
FOUNDATION	R.C.C.FOOTING IN 1:2:4 OVER C.C BED IN 1:5:10
BASEMENT SUPER STRUCTURE	C.R.S MASONRY IN CM 1:8
ROOFING	BRICK MASONRY IN CM 1:6
PLASTERING	R.C.C SLAB IN 1:2:4 IN CM 1:4
FLOORING	MABLE STONES
WOOD WORK	CUNTRY WOOD


REFERENCE	
D DOOR	3'-6" X 7'-0"
W WINDOW	5'-0" X 5'-0"
V VENTILATOR	5'-0" X 1'-0"

AREAS	SFT	SYD	SQM
PLOT AREA	640.50	104.05	87.40
ROAD EFFECTED AREA	60.00	8.66	5.57
NETT AREA	800.50	97.39	81.83
PLINTH AREA			
PROP: G.F	521.00	58.55	48.97
PROP: F.F	521.00	58.55	48.97
OPEN AREA	353.50	38.84	32.86
COMP.WALL	7150	(R.F.T)	


PROPOSED SHOWN IN RED  
EXISTING SHOWN IN BLUE

SET BACK	AS FOR G.O	AS FOR SITE
FRONT	1.50 M	1.50 M
REAR	0.00 M	0.00 M
SIDE- L	0.00 M	0.00 M
SIDE- R	0.00 M	1.37 M


OWNER'S SIGNATURE

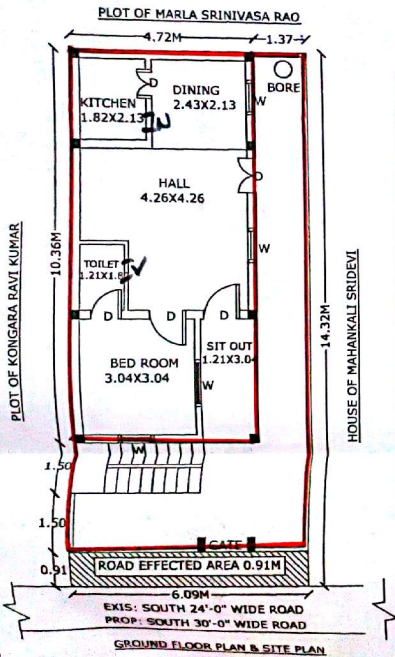

GROUND FLOOR PLAN & SITE PLAN

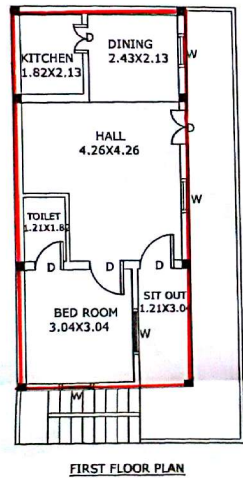

FIRST FLOOR PLAN

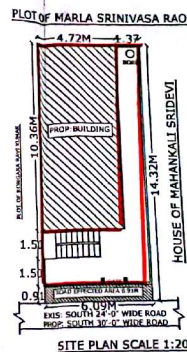

SITE PLAN SCALE 1:20

**SANCTIONED**  
Building permission accorded vide Proc.No. BCK/181/256/BA No. 113 /2015 Dated: 29-11-2015. Property existing on account of No. 38447. Property (Plan) & (Plan) No. 38447. Receipt No. 01401695 Dated: 27-10-2015 and this permission is valid upto 29-11-2018

**VASTHU REKHA**  
Architects Engineers & Builders  
Main Road, KODAD-502 001